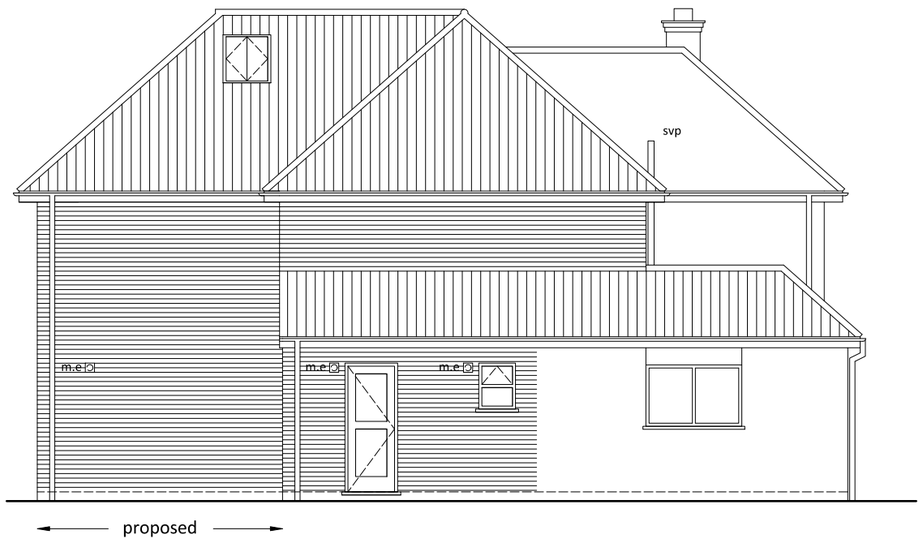

NORTH ELEVATION



SOUTH ELEVATION

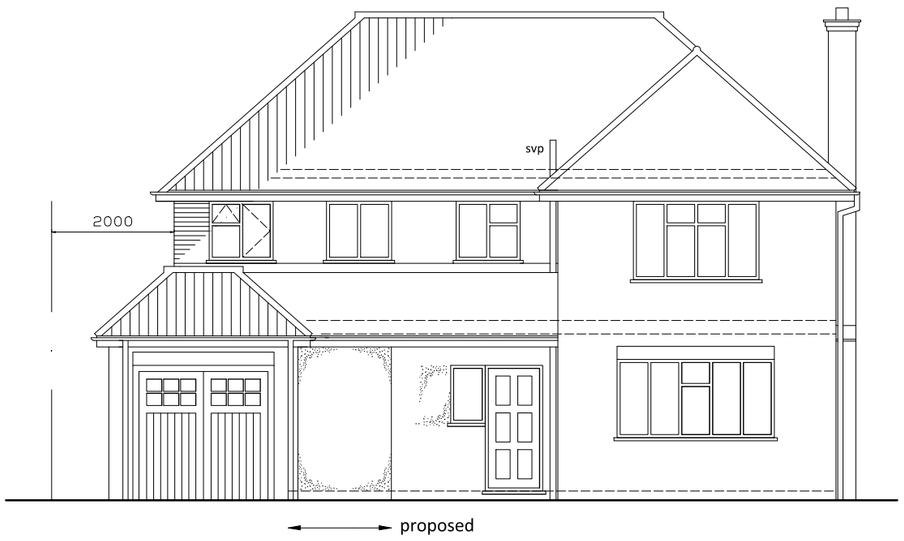

WEST ELEVATION

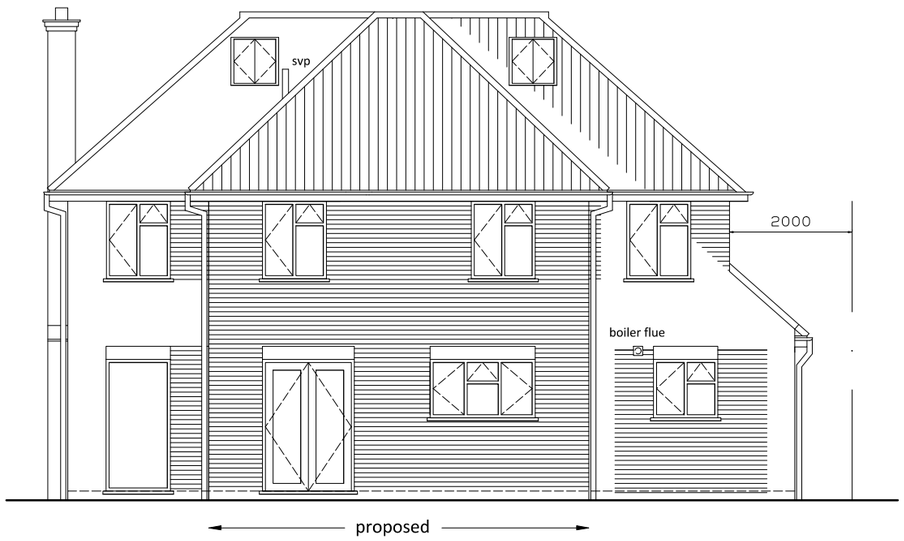

EAST ELEVATION

Notes
1. DO NOT SCALE FROM THIS DRAWING
2. CHECK ALL DIMENSIONS ON SITE

EXTERNAL MATERIALS
EXTENSION ROOF:
Clay plain tiles to match existing and crown roof finished in lead.

EXTENSION WALLS:
Brickwork to match existing

WINDOWS / DOORS:
White upvc casement windows with equal sight lines and leadedlights to match existing house. Timber hardwood doors finished in Dulux Heritage Blue Ribbon

RAINWATER GOODS:
Black half round upvc gutters and down pipes

PORCH WALLS:
Rendered and painted in white to match existing

ROOFLIGHTS
All new rooflights to be 780x1180mm double glazed Velux type conservation range finished in dark grey

0m. 3m.
ACTUAL SCALE

Revisions

A	SEP 16	BUILDING REGULATION REVISIONS ADDED
B	APR 18	AS BUILT AMENDMENTS

MORRIS & WEATHERALL
Chartered Architects

3 Maiden Street
Weston
Hitchin
Herts
SG4 7DG

tel: 01462 790401
fax: 01462 790726

Client

MRS NICHOL

Job title

PROPOSED EXTENSION
AND ALTERATIONS
AT
19 CLOISTERS ROAD
LETCHWORTH
HERTS.
SG6 3JR

Drawing title

PROPOSED ELEVATIONS

Scale	Date	Drawn
1:100	JUN 16	YBS

Drawing Number

NCL/4B