

PROPOSED
BLOCK PLAN
1:500 SCALE

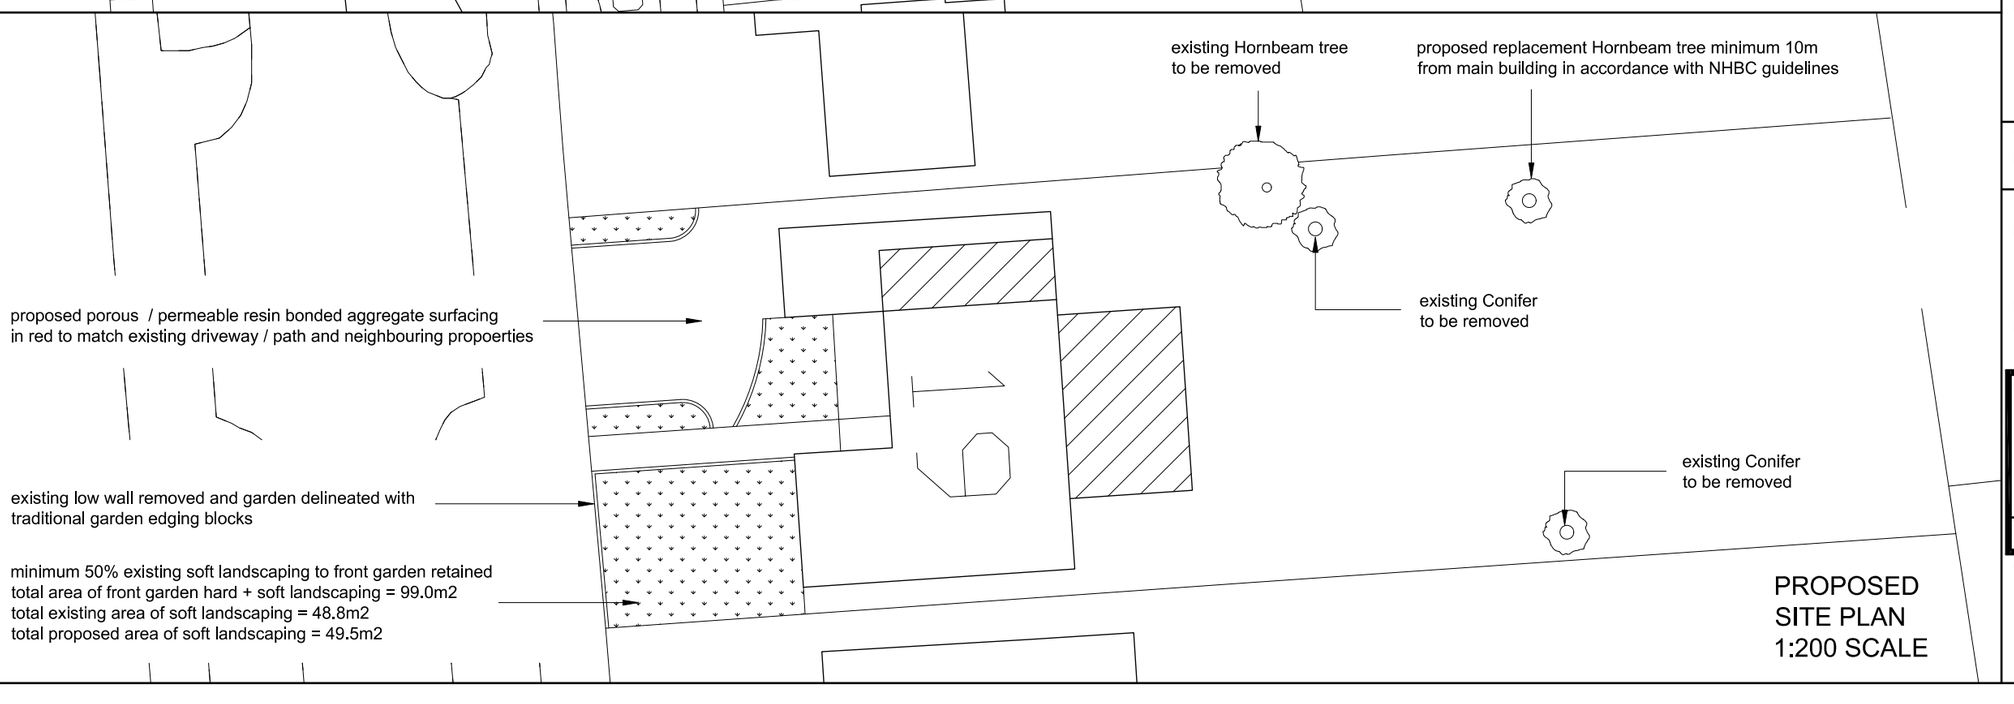

PROPOSED
SITE PLAN
1:200 SCALE

Notes
1. DO NOT SCALE FROM THIS DRAWING
2. CHECK ALL DIMENSIONS ON SITE

FOUNDATION DEPTH

Based on the promimity of the new Hornbeam tree which is a low water demand tree in assumed medium shrinkable soil to a mature height of 17m the foundation depth is 1000mm below ground level for the extensions. This is to be confirmed by Building Control on site.

0m. 10m.
ACTUAL SCALE

Revisions

A	SEP 16	BUILDING REGULATION REVISIONS ADDED
B	APR 18	AS BUILT AMENDMENTS

MORRIS & WEATHERALL
Chartered Architects

3 Maiden Street
Weston
Hitchin
Herts
SG4 7DG

tel: 01462 790401
fax: 01462 790726

Client

MRS NICHOL

Job title

PROPOSED EXTENSION
AND ALTERATIONS
AT
19 CLOISTERS ROAD
LETCHWORTH
HERTS.
SG6 3JR

Drawing title

PROPOSED
BLOCK PLAN

Scale	Date	Drawn
1:500 & 1:200	JUN 16	YBS

Drawing Number

NCL/5B