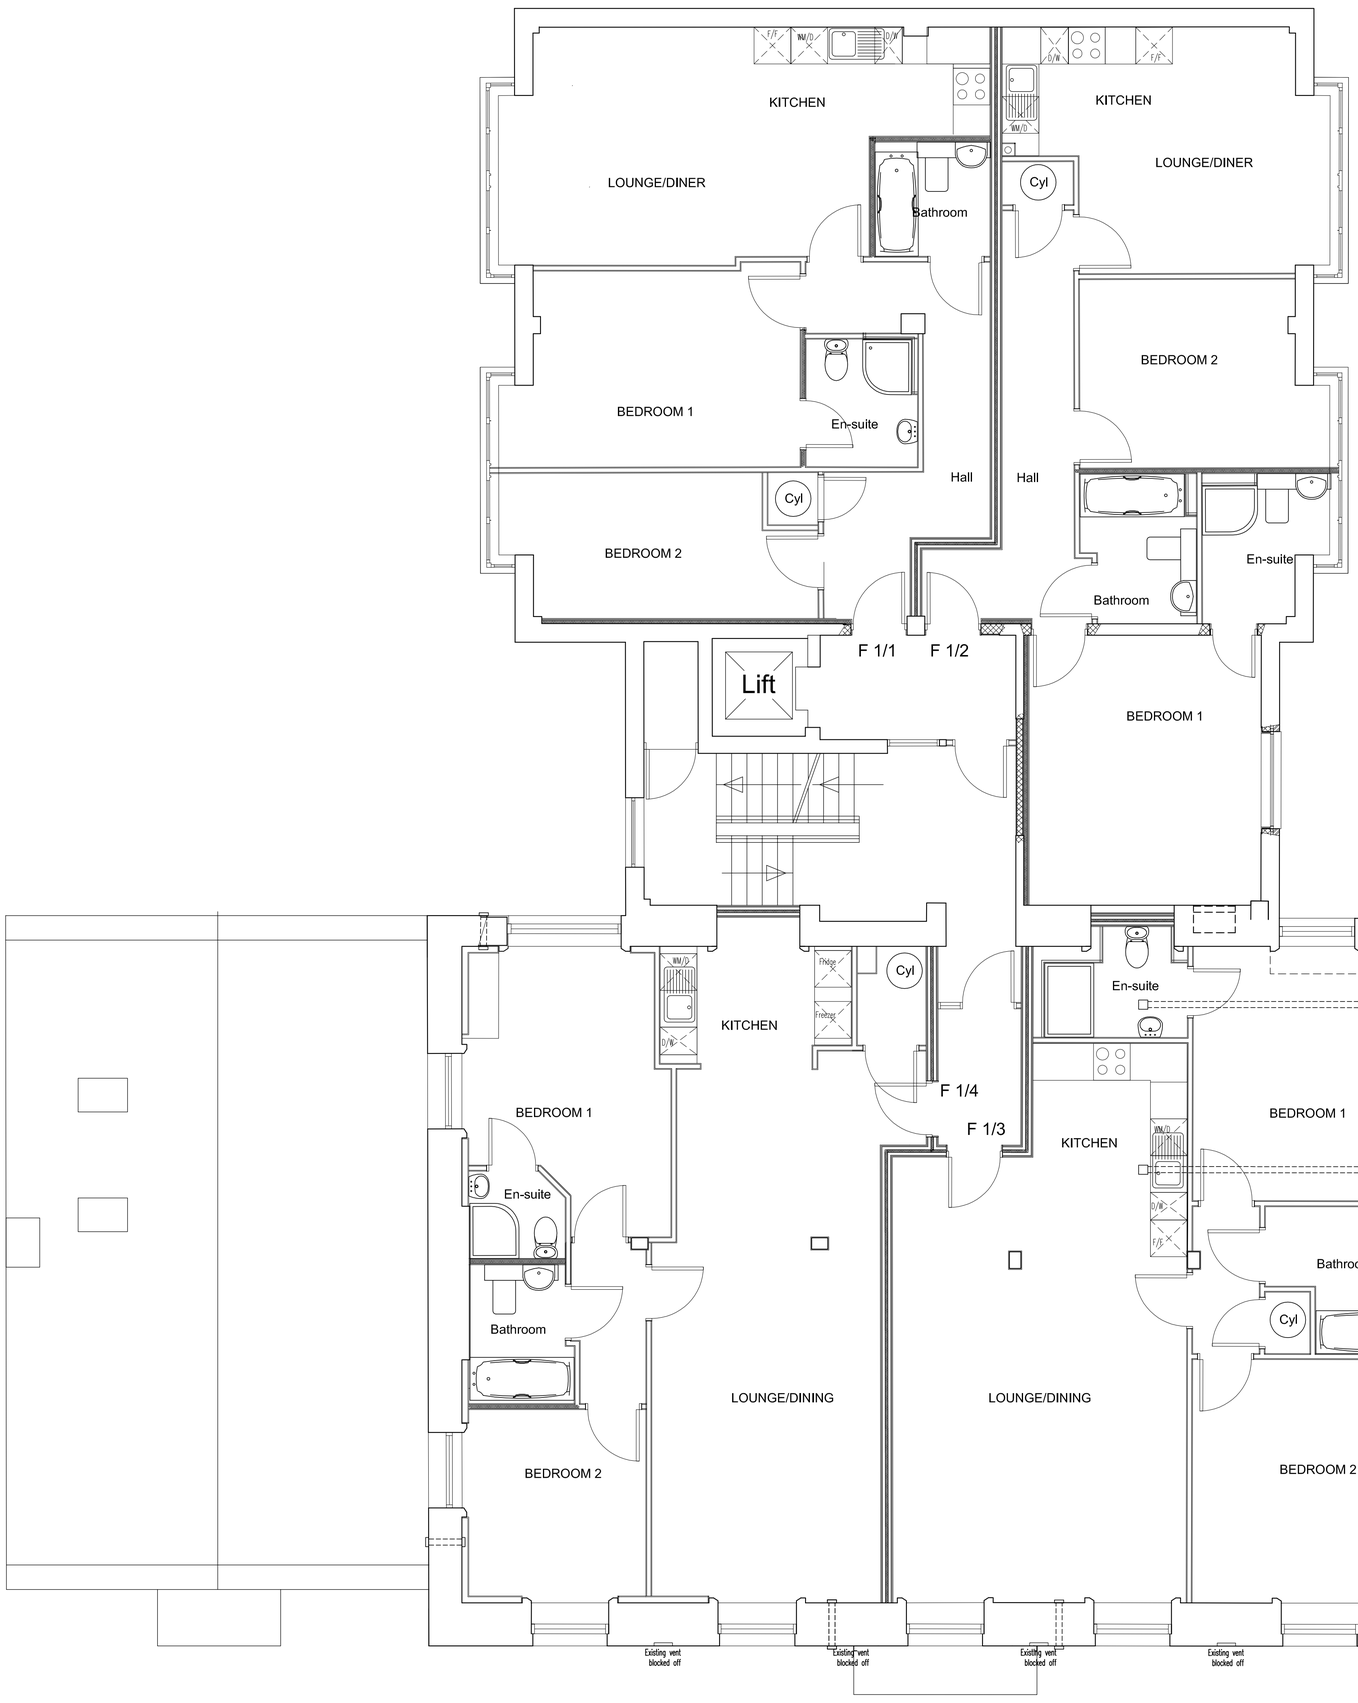

BLOCK B - FIRST FLOOR

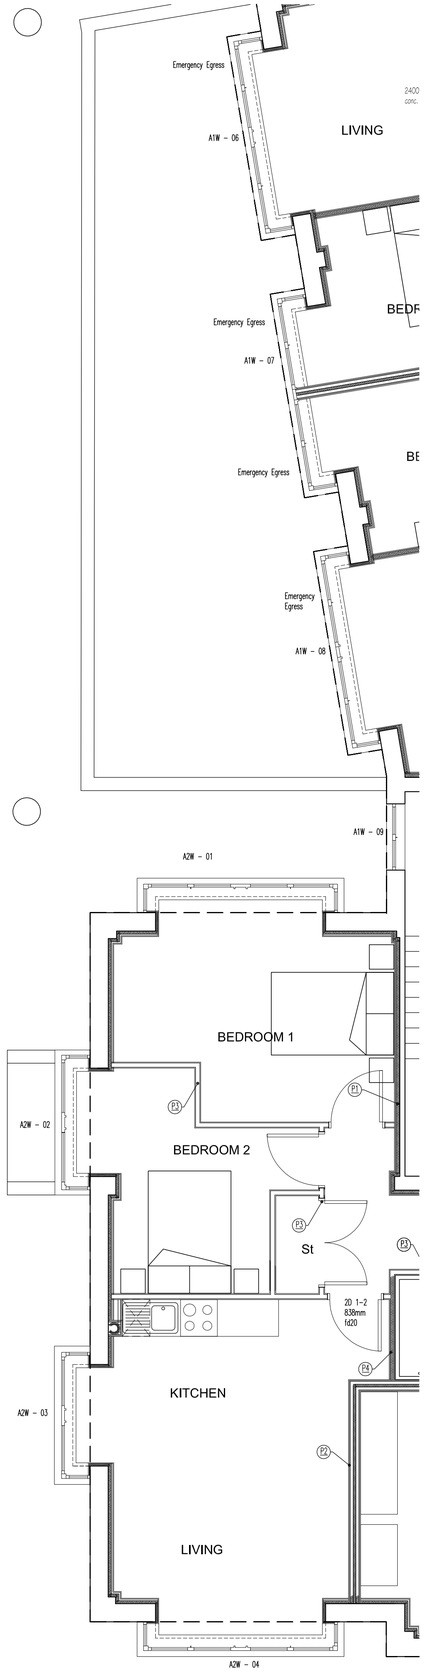

0 1m 5m

Scale 1:50

THIS DRAWING IS A PRINT AND MUST NOT BE SCALED. ANY QUERIES REGARDING DIMENSIONS TO BE TAKEN UP WITH PENTANGLE DESIGN GROUP.

ALL DIMENSIONS OF EXISTING BUILDINGS TO BE VERIFIED ON SITE.

THIS DRAWING IS THE COPYRIGHT OF PENTANGLE DESIGN GROUP AND SHALL NOT BE IN ANY WAY USED OR REPRODUCED WITHOUT THEIR PRIOR WRITTEN CONSENT.

NOTES

Rev.D 20-02-18 As Built Issue

AS BUILT

PENTANGLE
DESIGN GROUP
SUITE 1, 21 BANCROFT HITCHIN HERTS SG5 1JW
TEL(01462) 431133 E:PDG@PENTANGLE.DESIGN.CO.UK

JOB TITLE

PROPOSED CONVERSION OF OFFICE ACCOMMODATION TO RESIDENTIAL, LATCHMORE COURT, HITCHIN, HERTS

DRAWING TITLE

BLOCK B - AS PROPOSED FIRST FLOOR PLAN

SCALE	DRAWING NUMBER	REVISION
1:50 @A1	53	D
DATE Sept '16		
SERIAL No.		
JOB NUMBER 3293		

ARCHITECTS & INTERIOR DESIGNERS