



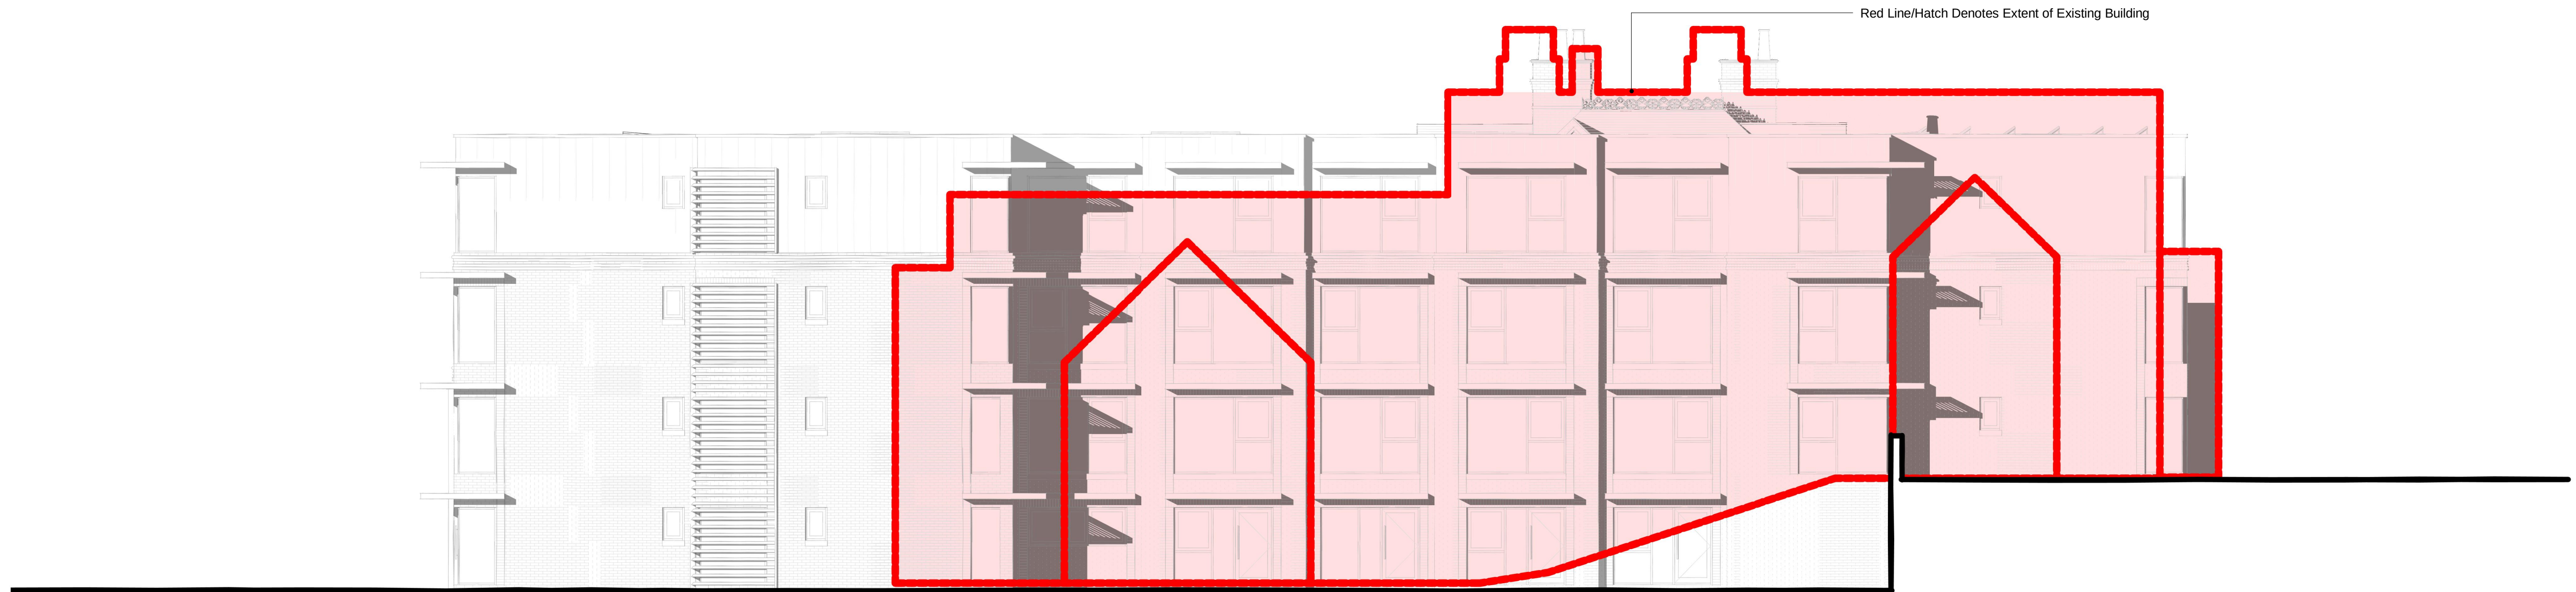

1 South-East Elevation - Proposed Massing
1 : 100



2 North-East Elevation - Proposed Massing
1 : 100

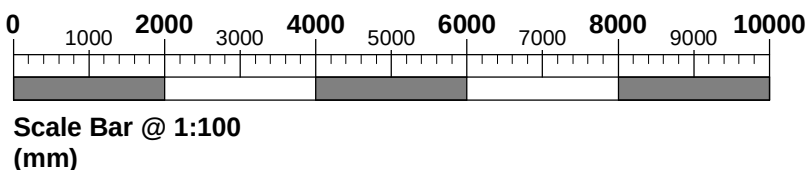


KEY / LEGEND

Red Line/Hatch Denotes Extent of Existing Building

C	General update for Detailed Planning Submission	GDC	30/10/24
B	Updated to Planning Status	AM	05/06/24
A	General update for 'Pre-Application Advice' submission.	GDC	27/09/23
Rev	Description	Auth	Date

STAMP	PLANNING
-------	----------

PROJECT STATUS	Developed Design
----------------	------------------

DRAWING TITLE
Proposed Massing Elevations
(Indicating Extent of Existing Care Home)
Sheet 1 of 2

PROJECT
Guysfield Care Home at
Willian Road, Willian, Letchworth for
Caring Homes Group Ltd

DATE CREATED	DESIGNER	SCALE @ A1
12/12/22	GDC	1 : 100

ORIGINATOR PROJECT NUMBER	4870
---------------------------	------

ISO DOCUMENT REF.	REV.
4870-ORA-01-ZZ-DR-A-33201	C

ora architects
A: Pitreavie Drive,
Dunfermline, KY11 8UH
T: 01383 621621
W: oliverandrobb.co.uk
Members: David M Tibbs Gary D Caudrey Graeme S Gallagher